



LOWER FLOOR

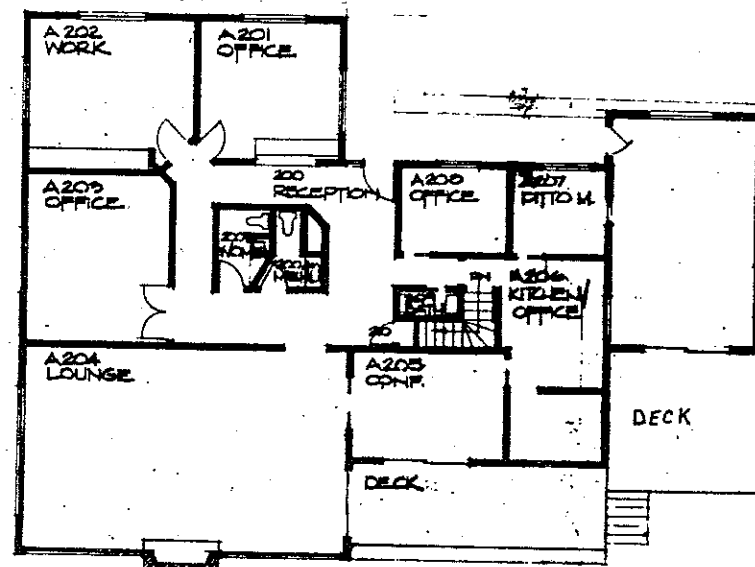


MAIN FLOOR


ALUMNI HOUSE

AS-BUILT JULY 1976

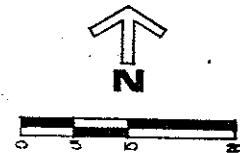

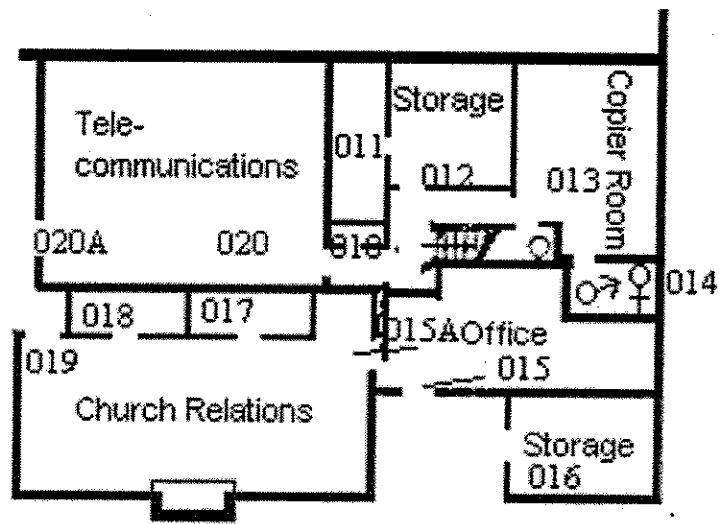

Lower Floor

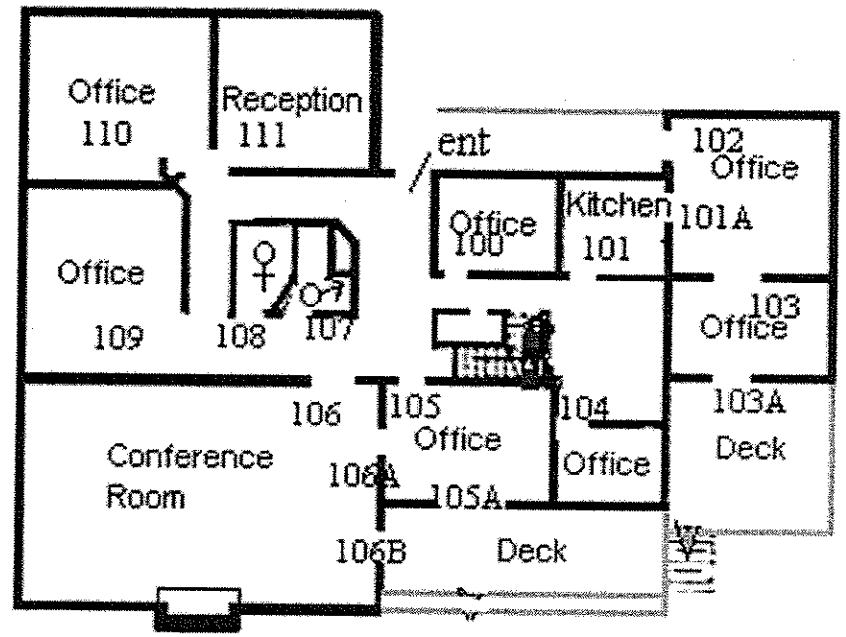

Main Floor

Nesvig Alumni Center August 2001

NOT DRAWN TO SCALE