



KREIDLER HALL - BASEMENT FLOOR PLAN
22x34 - 1/8" = 1'-0"
11x17 - 1/16" = 1'-0"




KREIDLER HALL - FIRST FLOOR PLAN
22x34 - 1/8" = 1'-0"
11x17 - 1/16" = 1'-0"

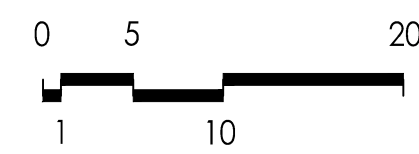

KEY
 ○ ROOM NUMBER
 □ DOOR NUMBER

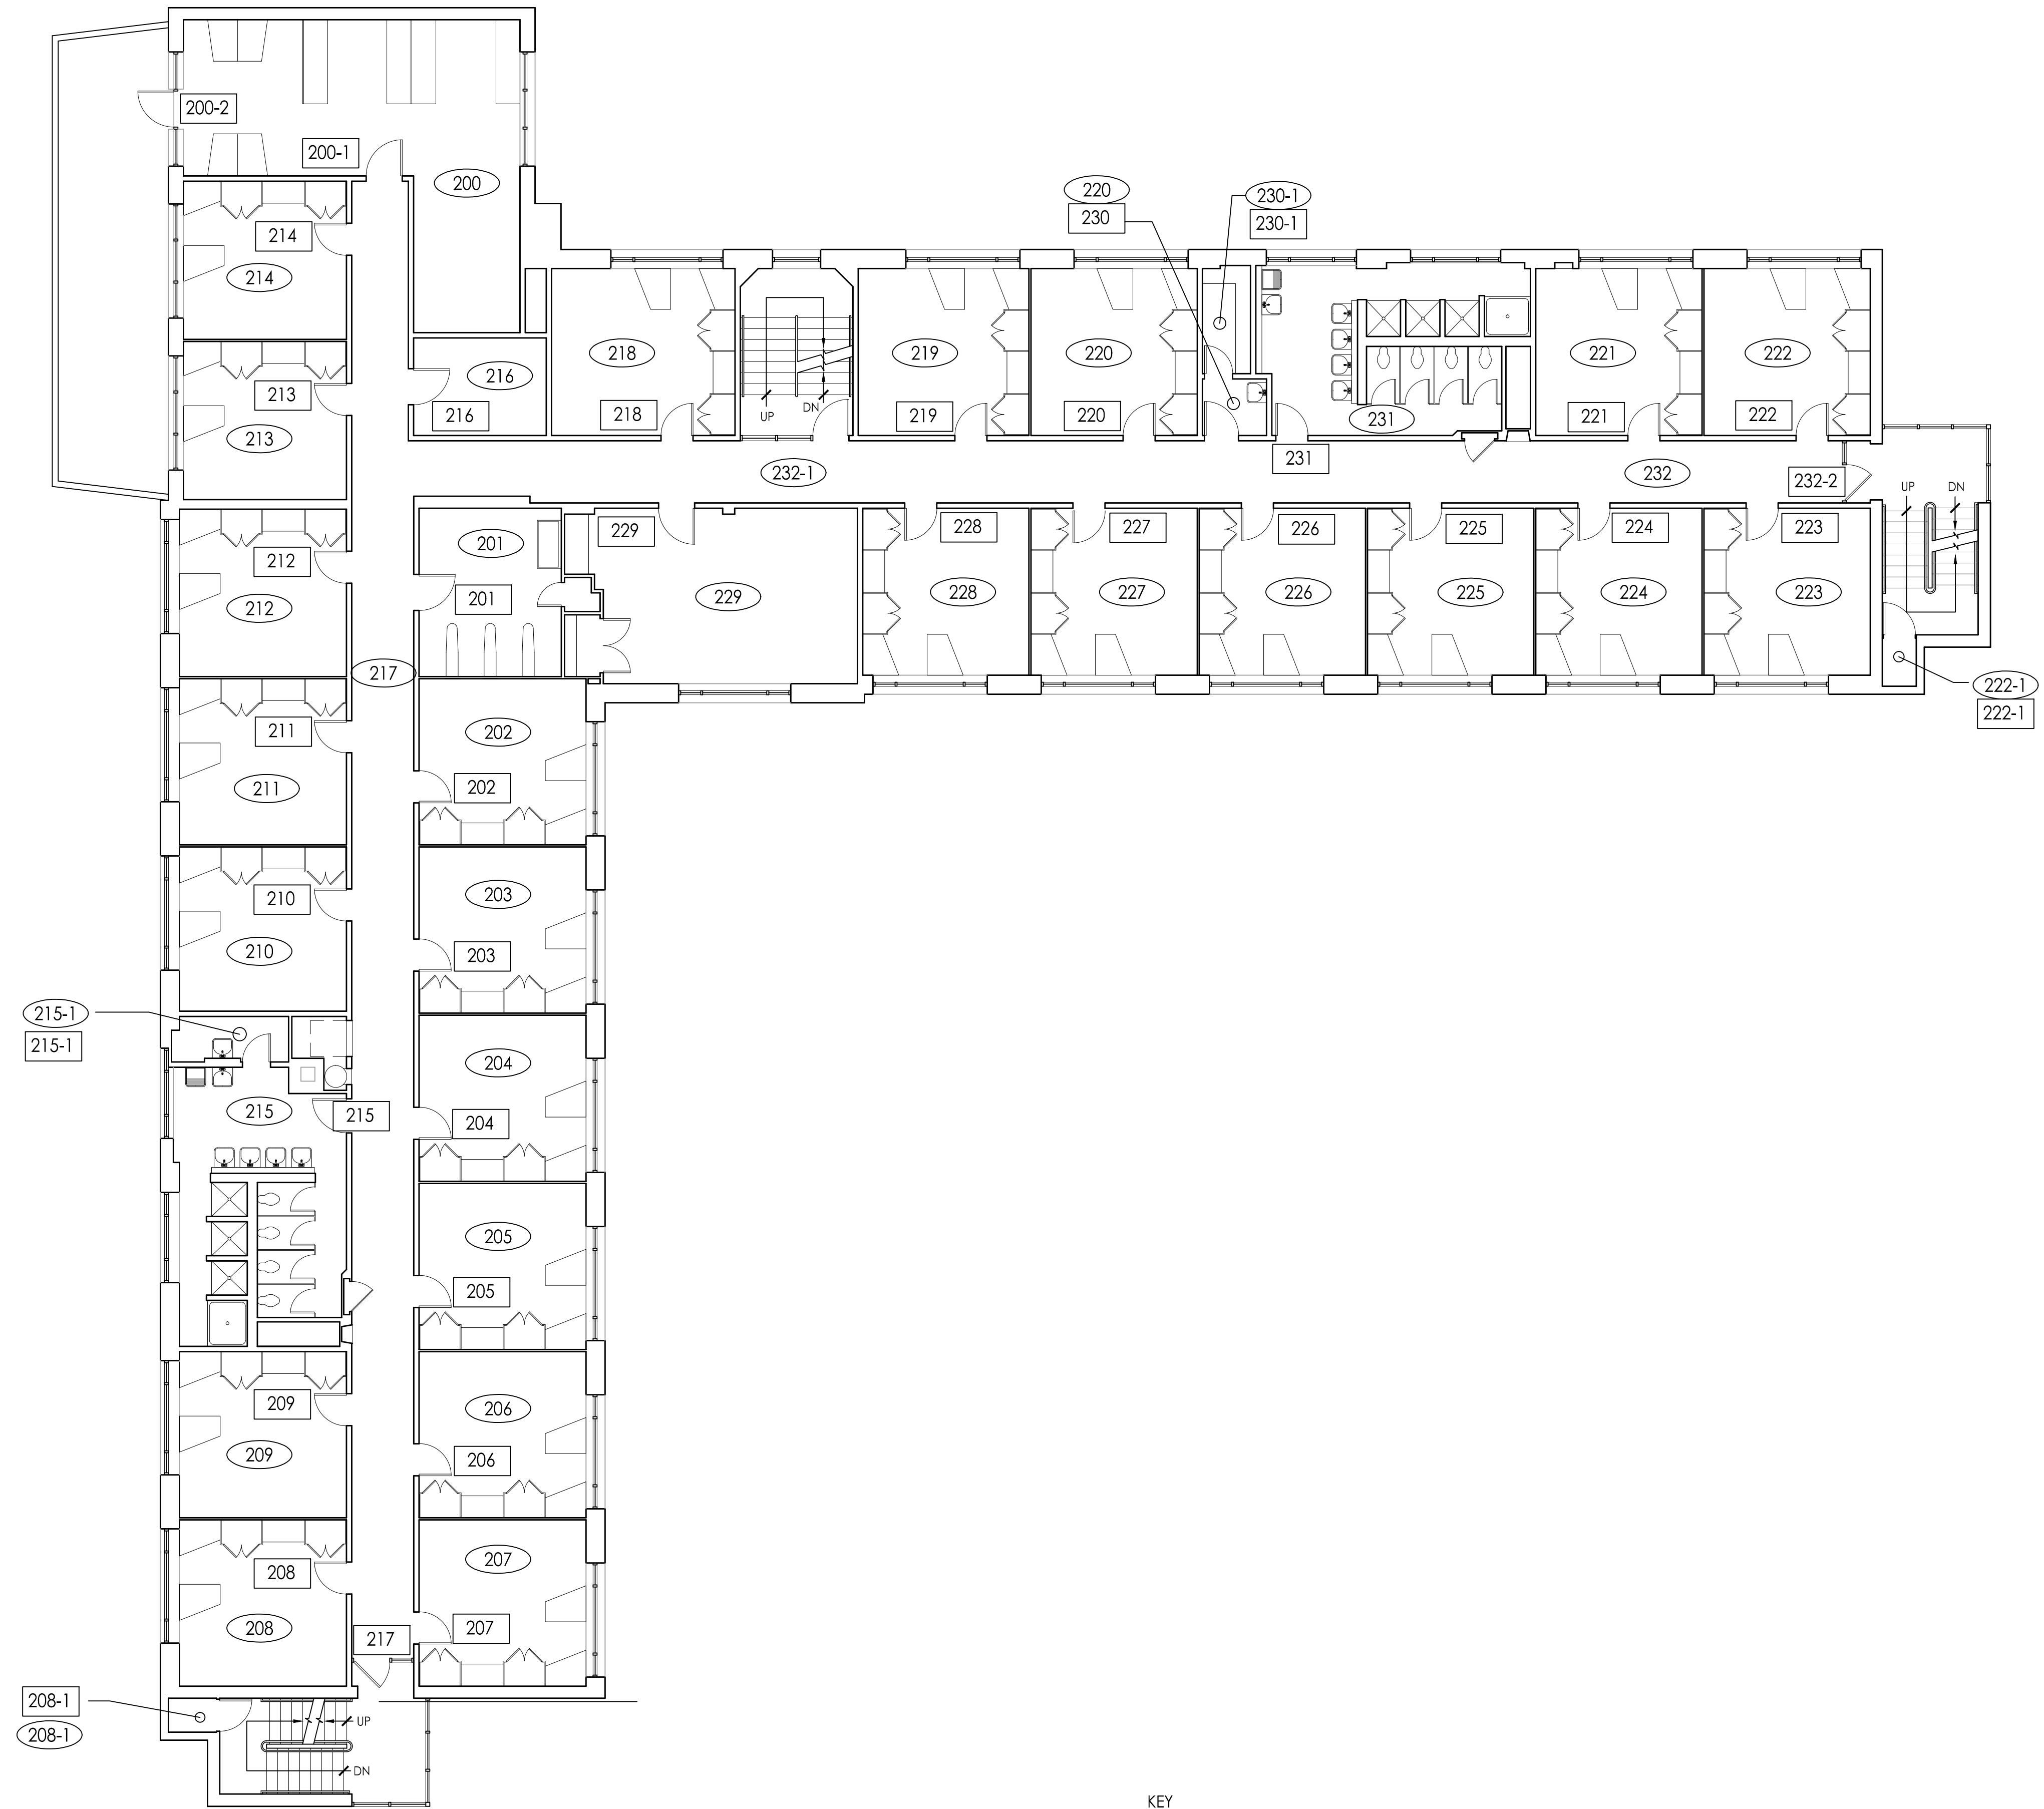



KREIDLER HALL - SECOND FLOOR PLAN
22x34 - 1/8" = 1'-0"
11x17 - 1/16" = 1'-0"

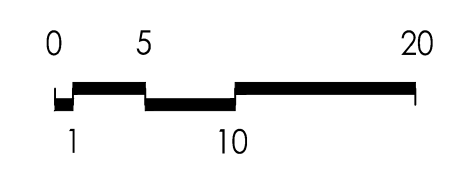

KEY
 ○ ROOM NUMBER
 □ DOOR NUMBER


Second Floor Plan
PACIFIC LUTHERAN UNIVERSITY
 KREIDLER HALL - AS-BUILT

Job #:
Date: August 7, 2014
Revs:

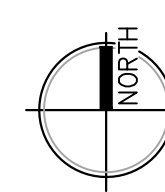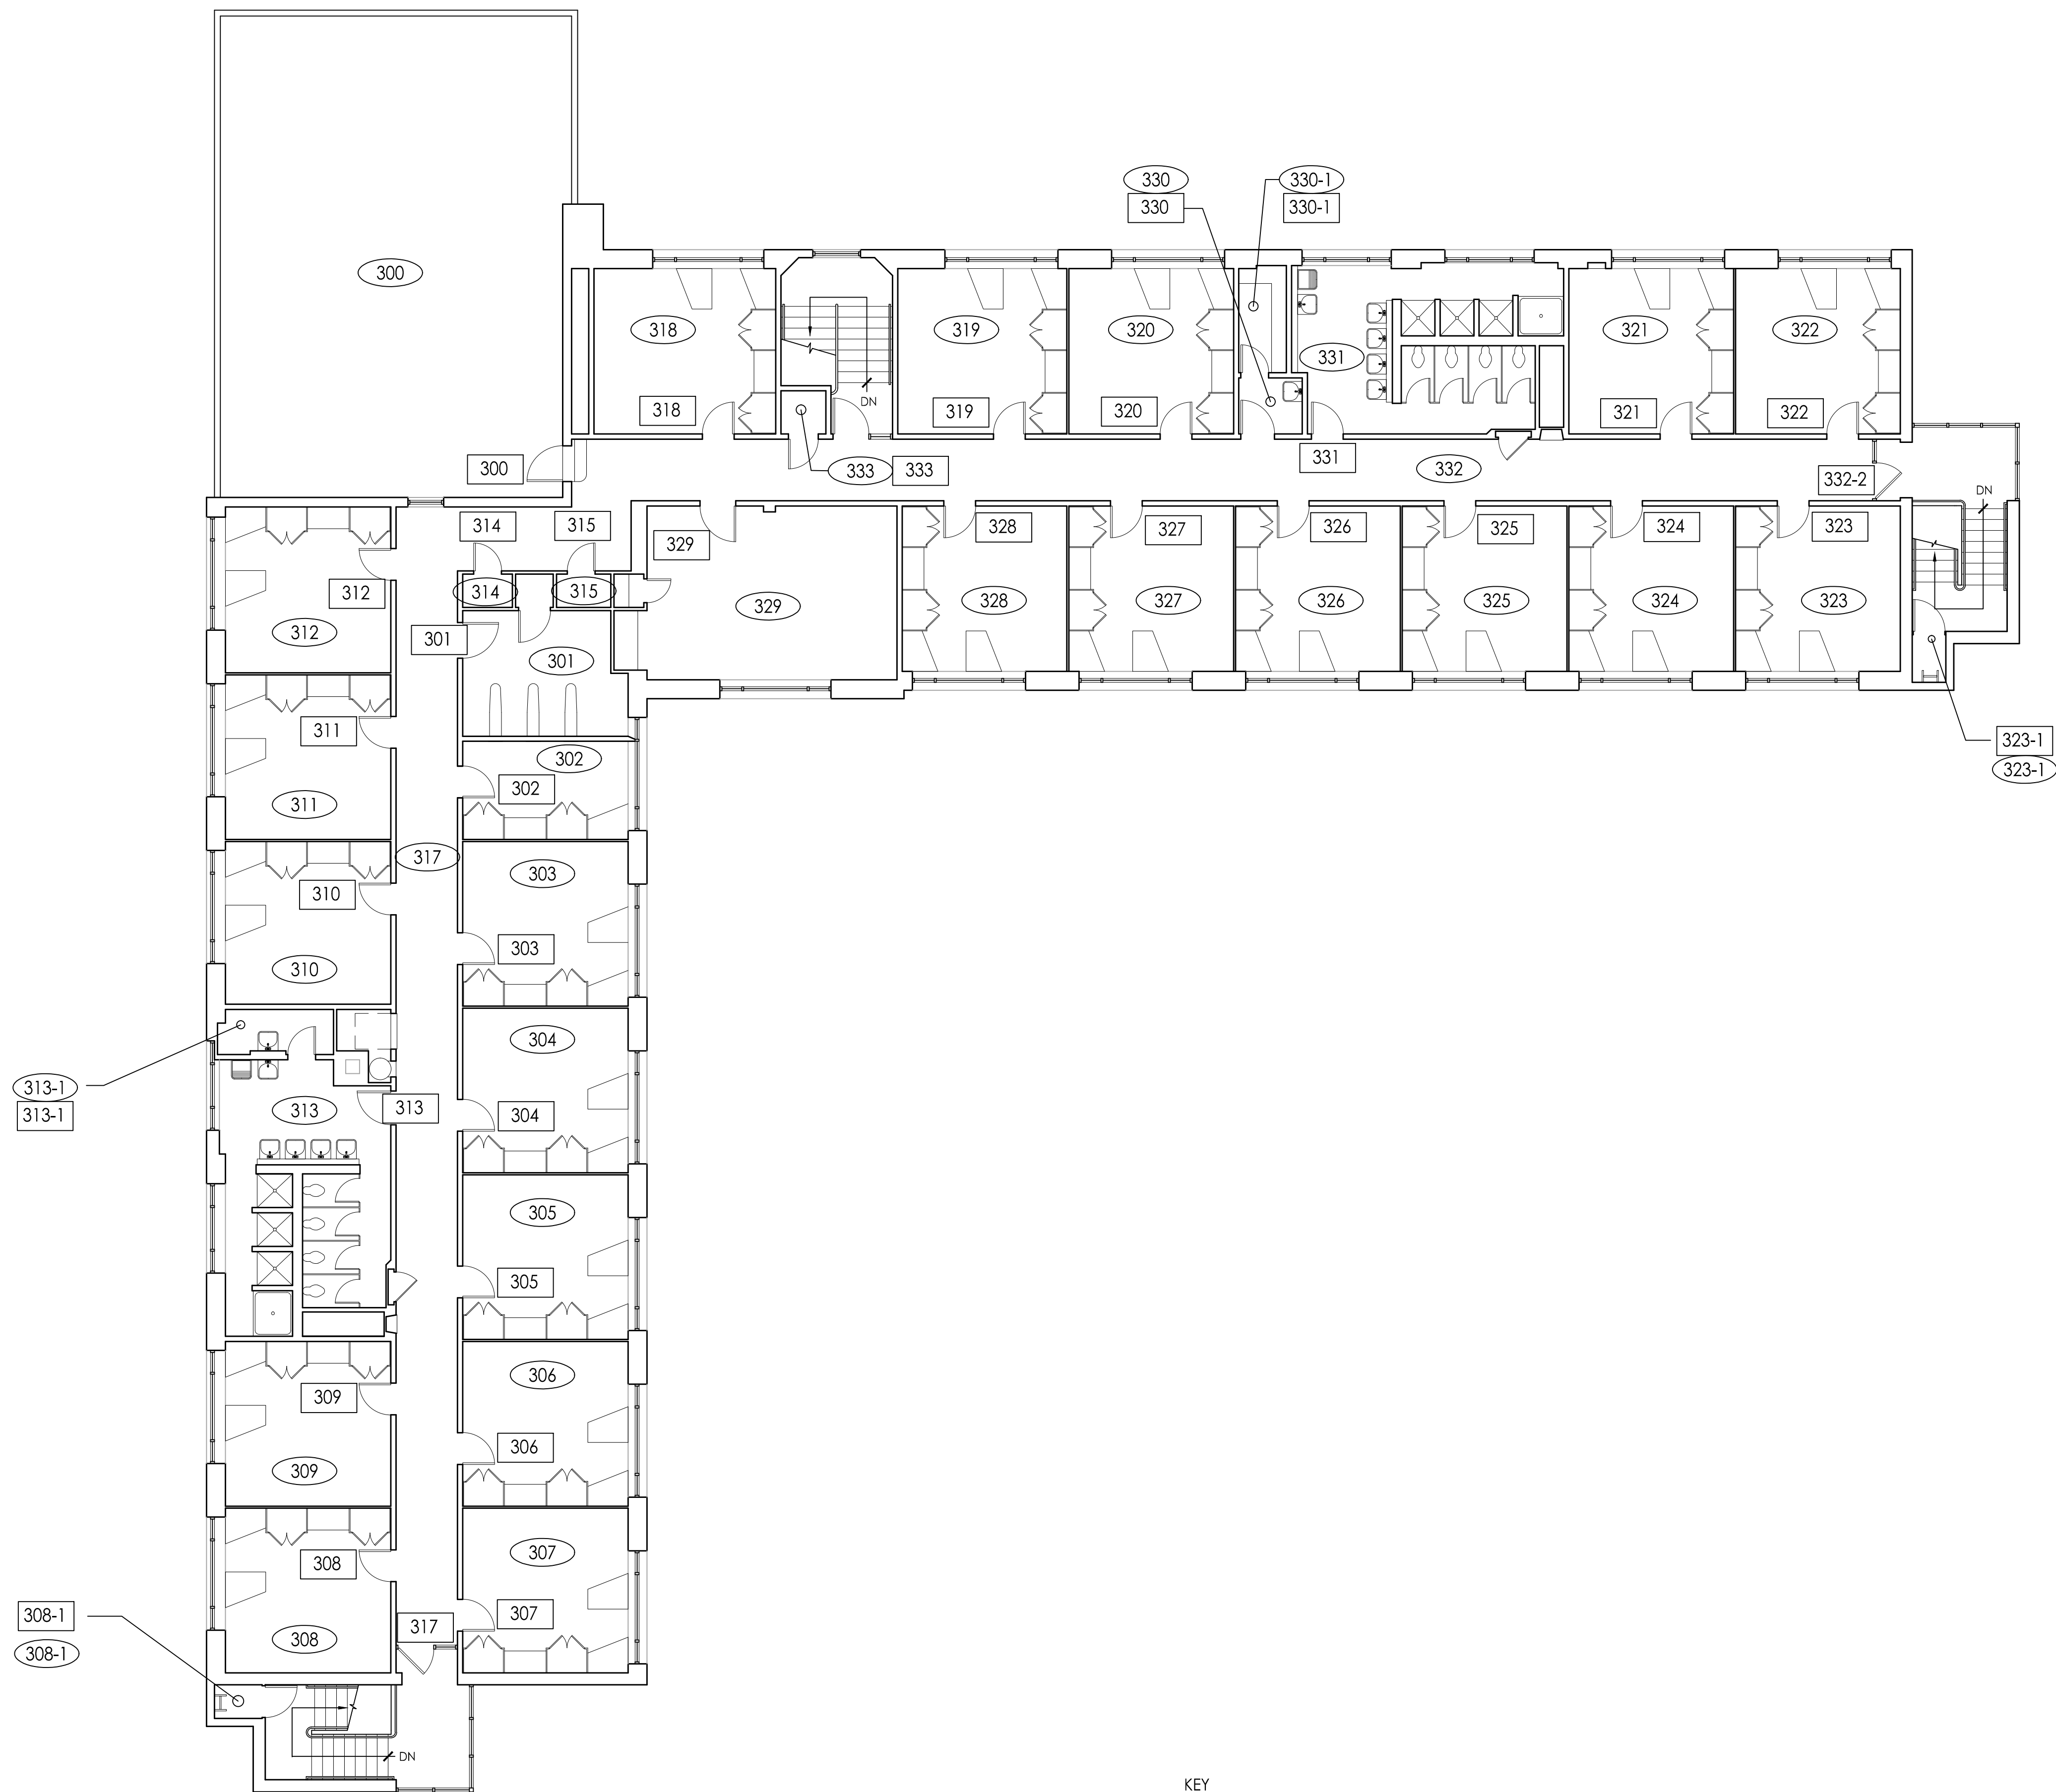

KREIDLER HALL - THIRD FLOOR PLAN

22x34 - 1/8" = 1'-0"
11x17 - 1/16" = 1'-0"

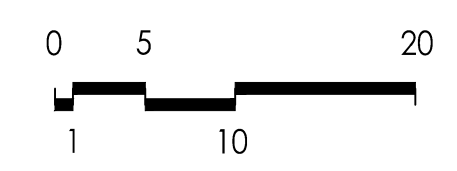

KEY

000	ROOM NUMBER
000	DOOR NUMBER

Third Floor Plan
PACIFIC LUTHERAN UNIVERSITY
KREIDLER HALL - AS-BUILT

Job #:
Date: August 7, 2014
Revs: