


PFLUEGER RESIDENCE HALL - FIRST FLOOR


22x34 - 3/32" = 1'-0"
11x17 - 3/64" = 1'-0"

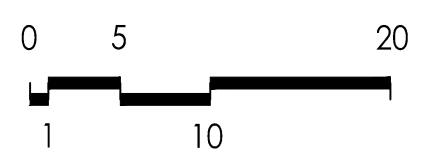


- KEY**
- 000 ROOM NUMBER
 - 000 DOOR NUMBER

First Floor Plan
PACIFIC LUTHERAN UNIVERSITY
PFLUEGER RESIDENCE HALL - AS-BUILT


Job #:
Date: August 7, 2014
Revs:

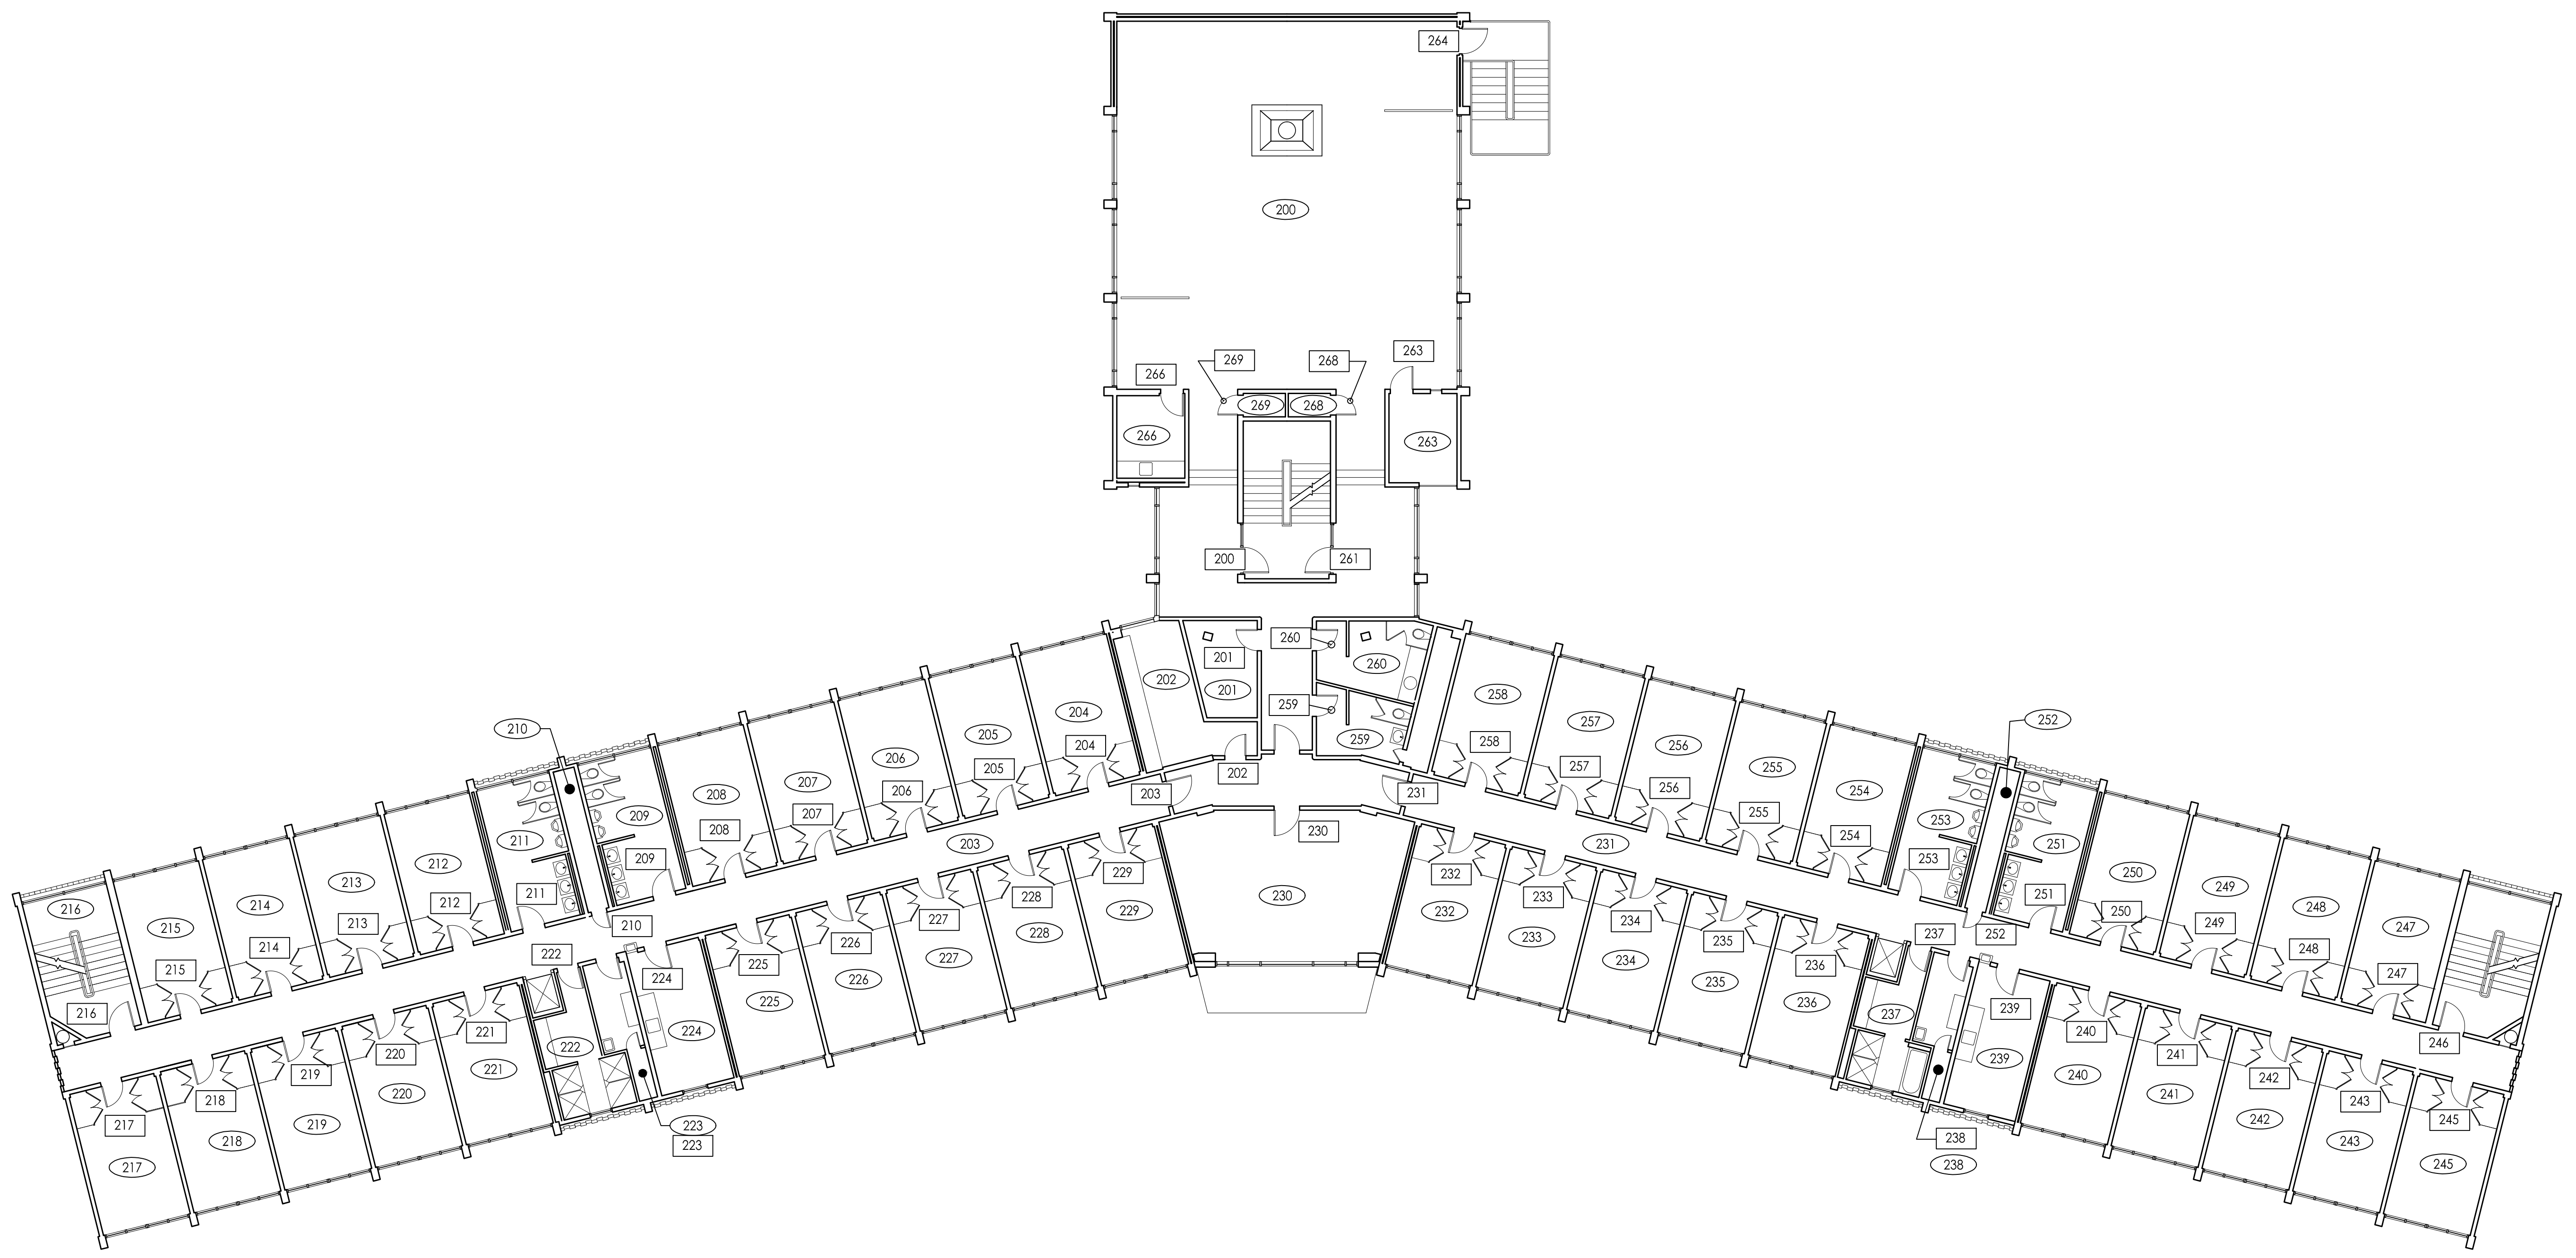

PFLUEGER RESIDENCE HALL - SECOND FLOOR

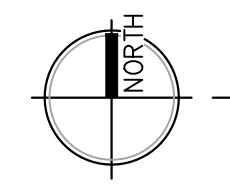



22x34 - 3/32" = 1'-0"
11x17 - 3/64" = 1'-0"

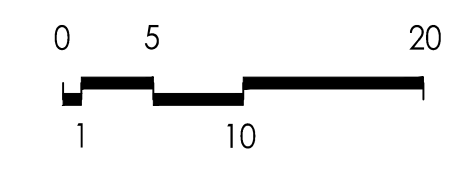

- KEY**
- 000 ROOM NUMBER
 - 000 DOOR NUMBER


Second Floor Plan
PACIFIC LUTHERAN UNIVERSITY
PFLUEGER RESIDENCE HALL - AS-BUILT

Job #:
Date: August 7, 2014
Revs:

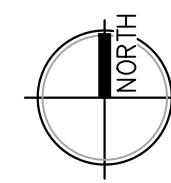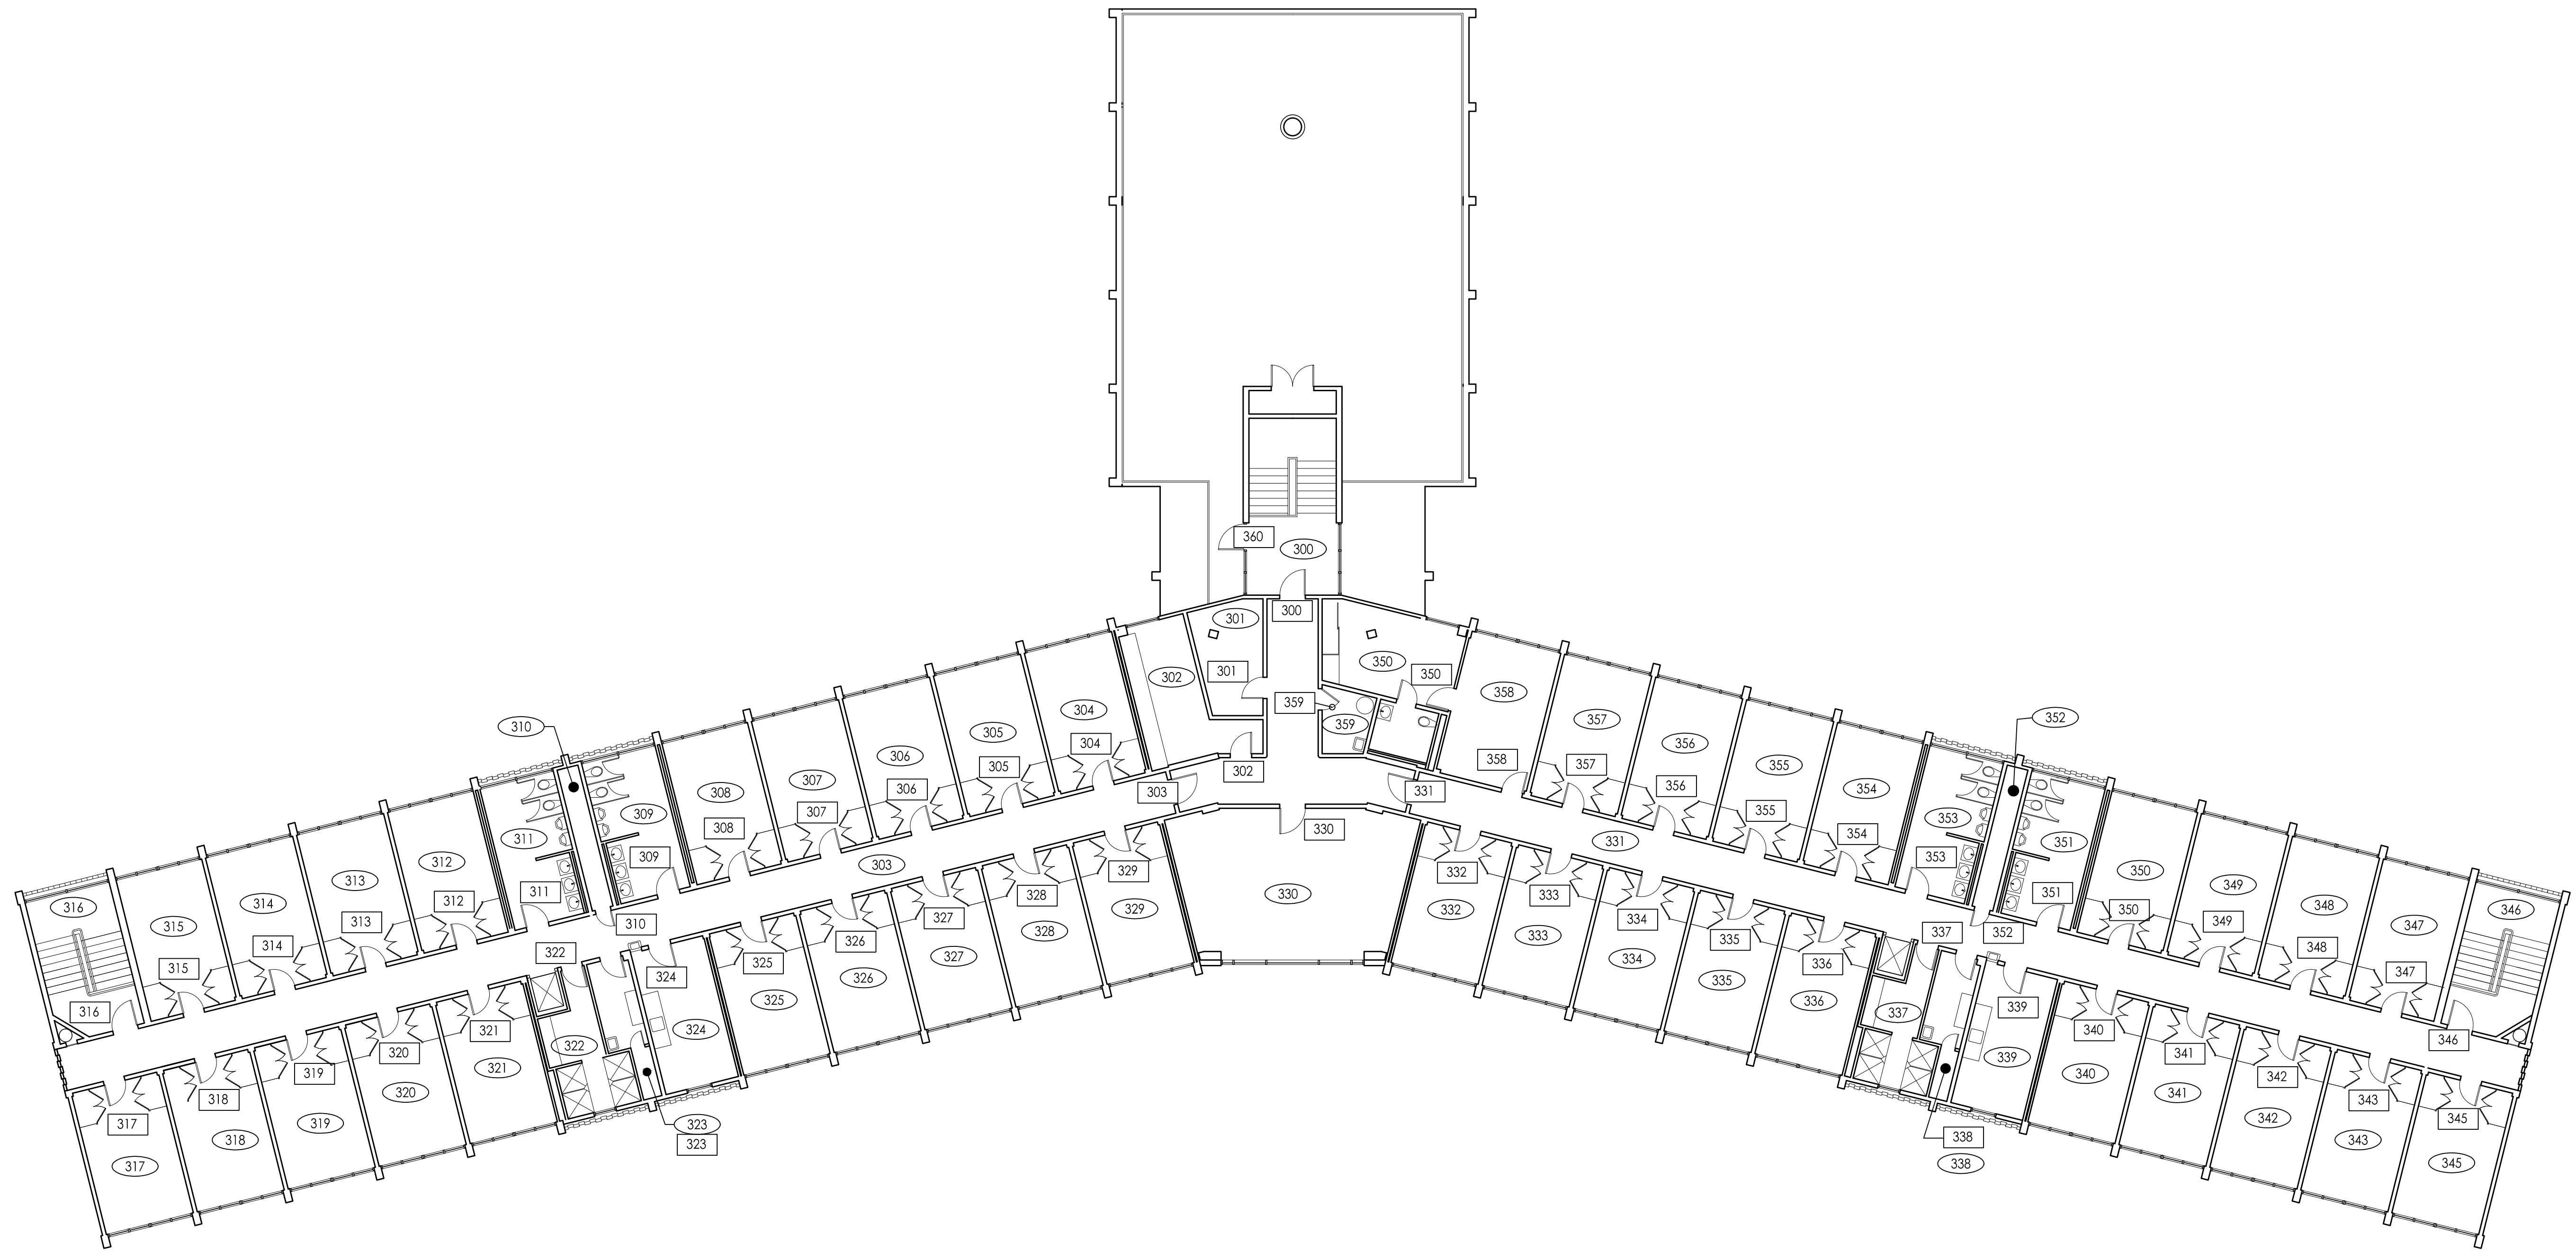

PFLUEGER RESIDENCE HALL - THIRD FLOOR

22x34 - 3/32" = 1'-0"
11x17 - 3/64" = 1'-0"

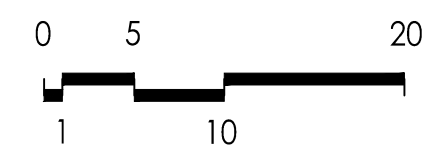

- KEY**
- 000 ROOM NUMBER
 - 000 DOOR NUMBER

Third Floor Plan

PACIFIC LUTHERAN UNIVERSITY
PFLUEGER RESIDENCE HALL - AS-BUILT