



HARSTAD HALL - FIRST FLOOR PLAN
 22x34 - 1/8" = 1'-0"
 11x17 - 1/16" = 1'-0"

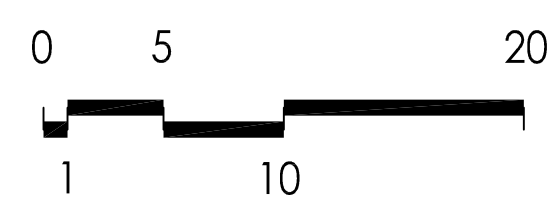


KEY
 ○ ROOM NUMBER
 □ DOOR NUMBER

First Floor Plan
 PACIFIC LUTHERAN UNIVERSITY
 HARSTAD HALL - AS-BUILT

Job #:
 Date: August 7, 2014
 Revs:

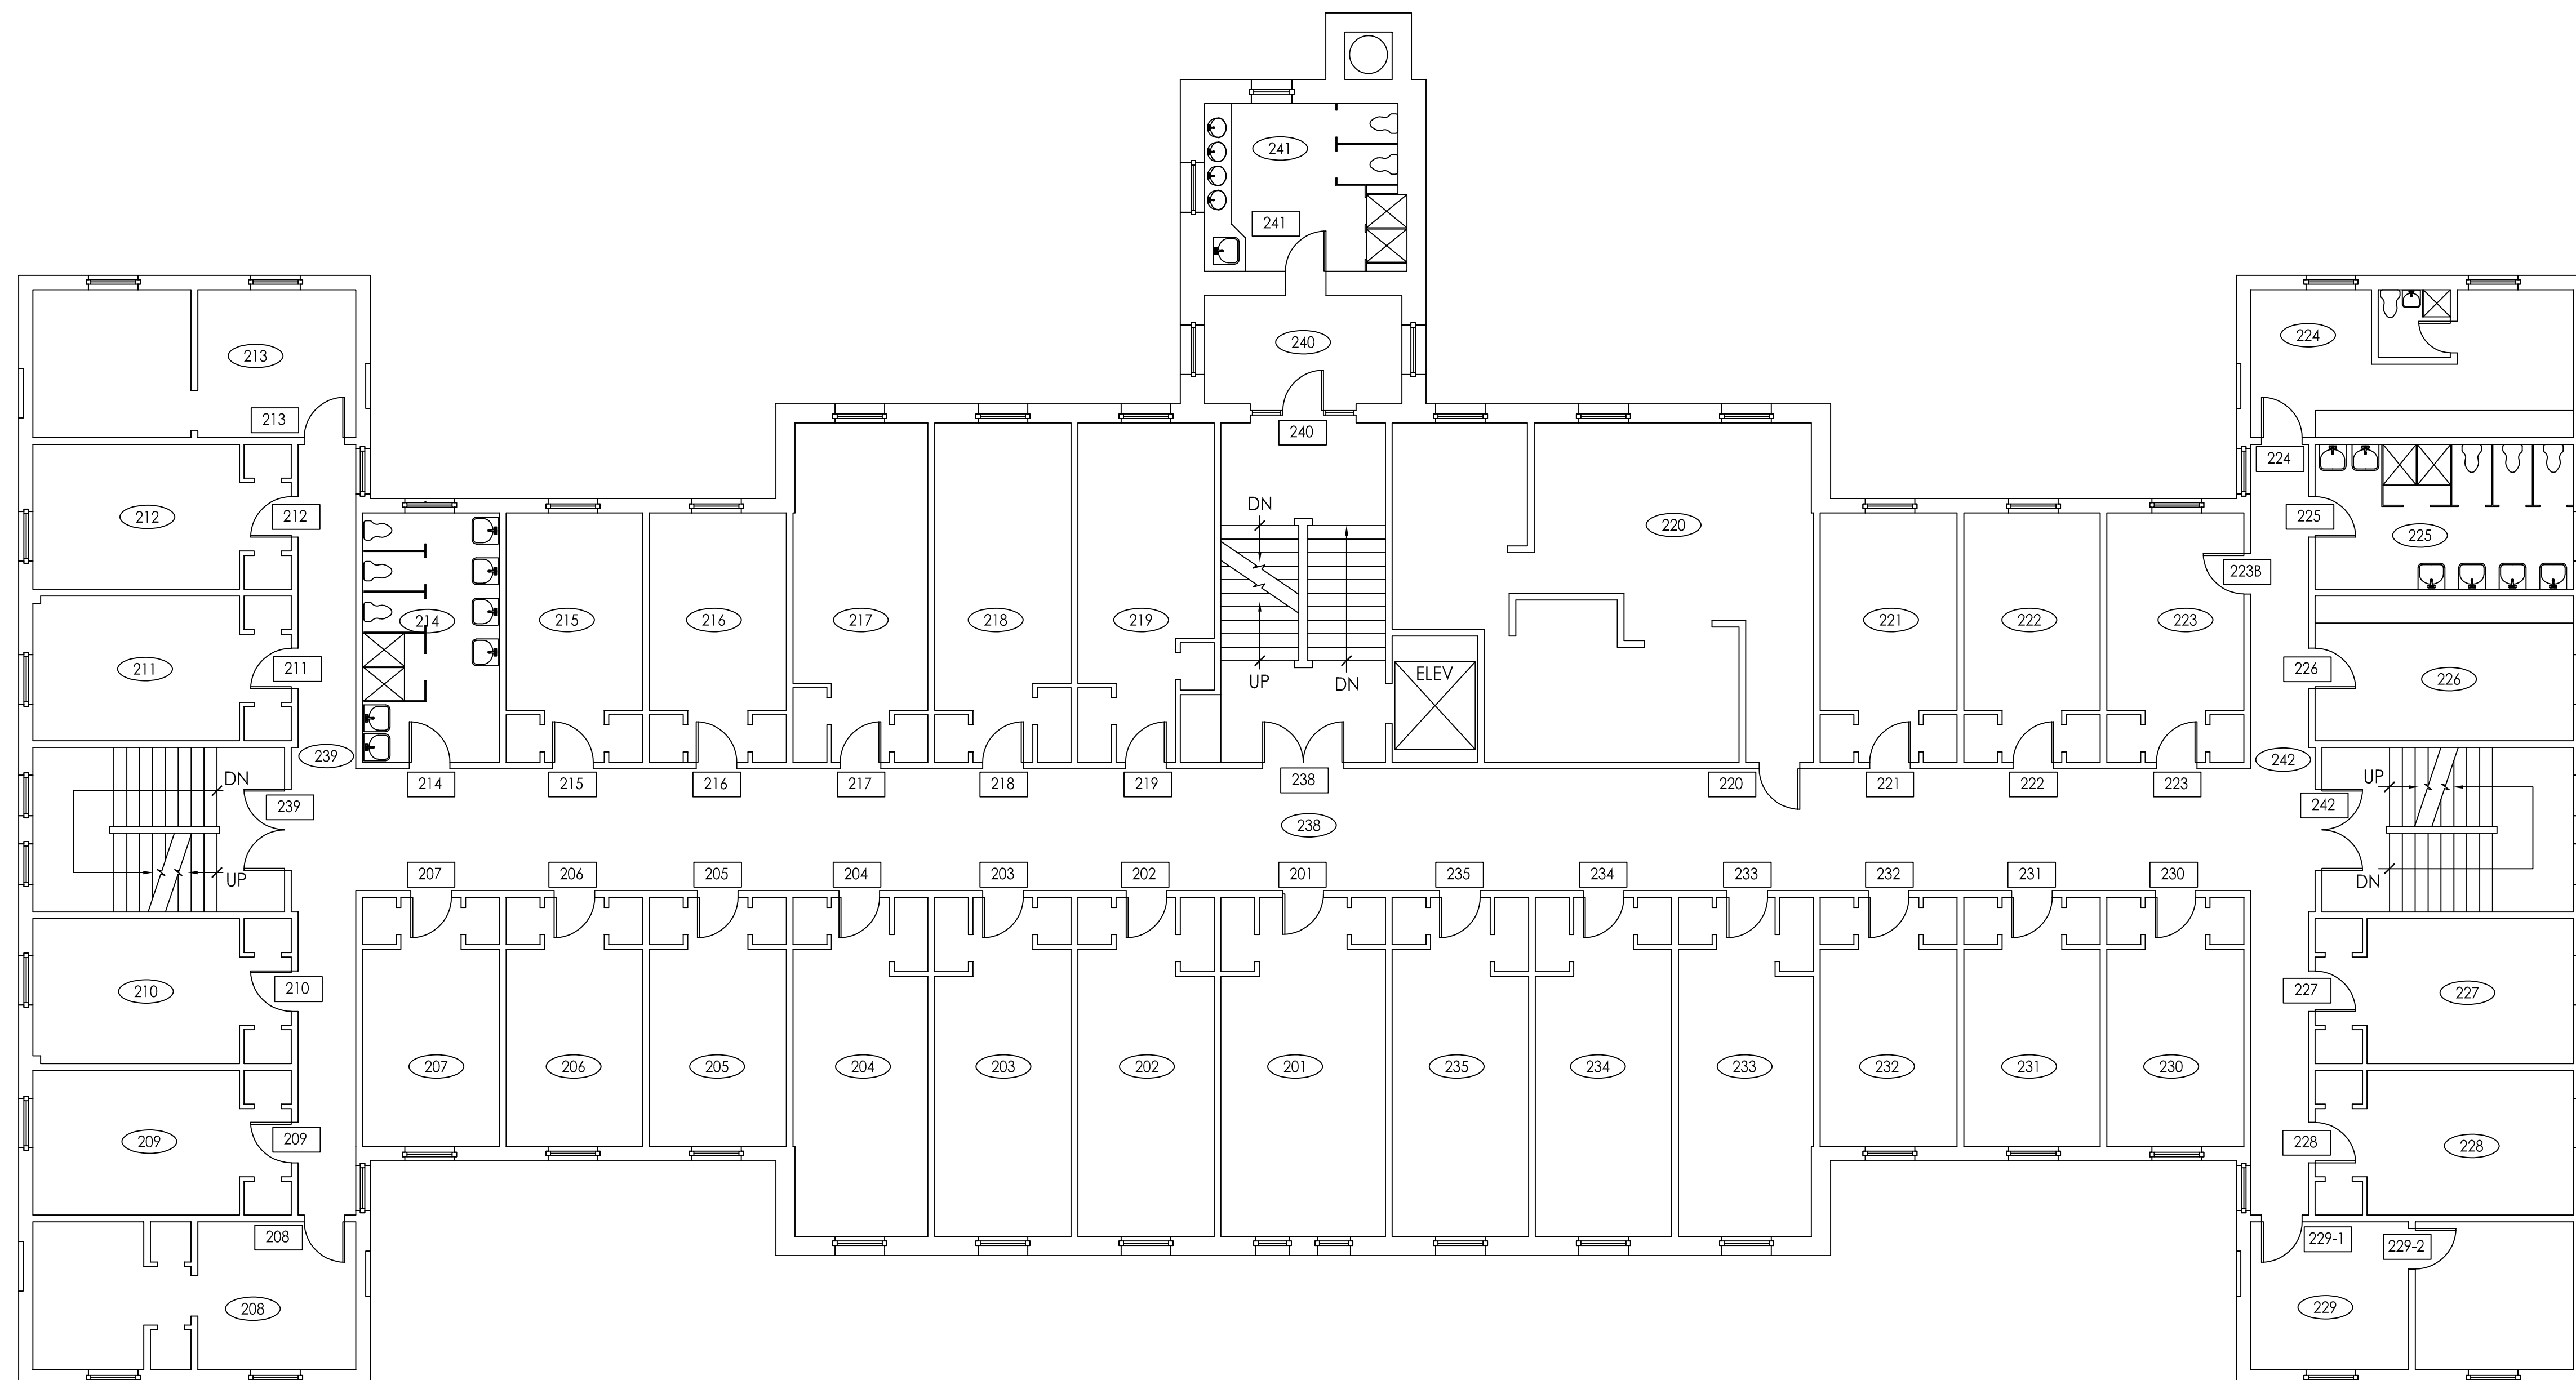


HARSTAD HALL - SECOND FLOOR PLAN
 22x34 - 1/8" = 1'-0"
 11x17 - 1/16" = 1'-0"

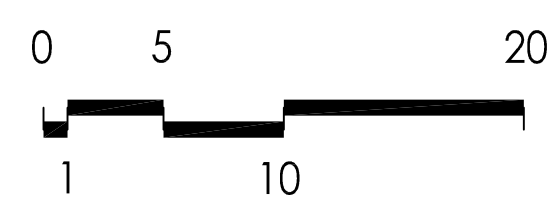


KEY
 ○ ROOM NUMBER
 □ DOOR NUMBER

Second Floor Plan
PACIFIC LUTHERAN UNIVERSITY
HARSTAD HALL - AS-BUILT

Job #:
 Date: August 7, 2014
 Revs:

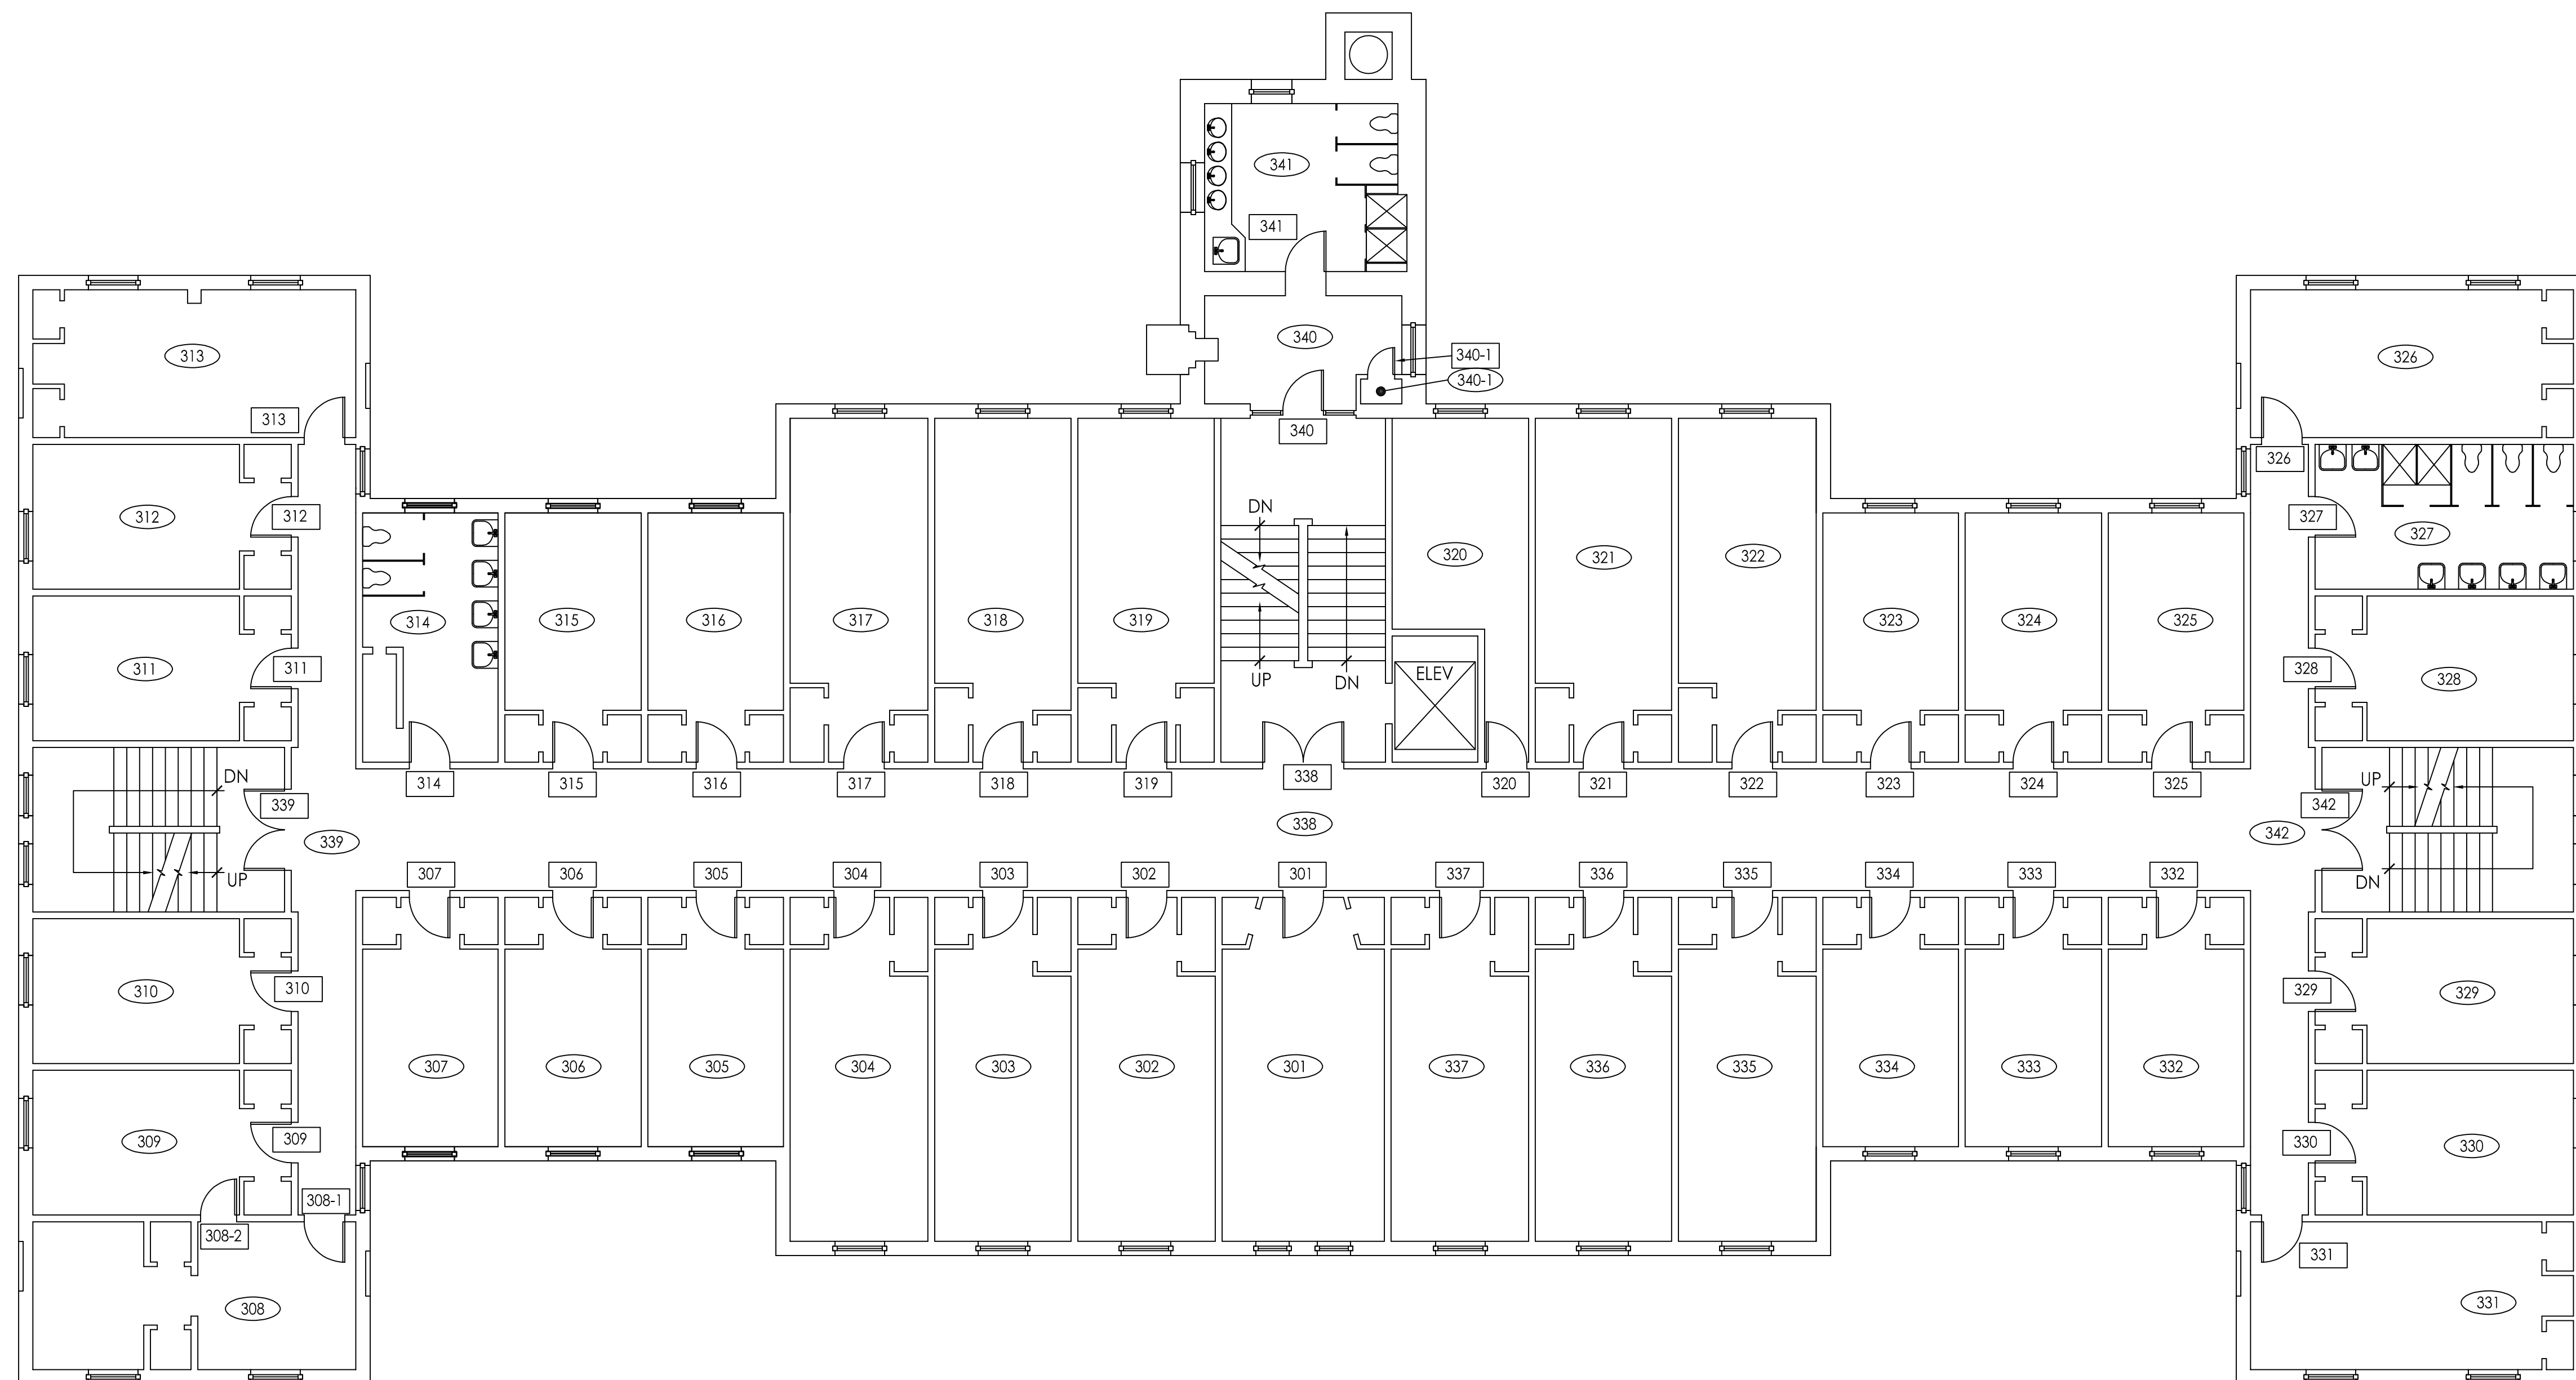

HARSTAD HALL - THIRD FLOOR PLAN
 22x34 - 1/8" = 1'-0"
 11x17 - 1/16" = 1'-0"


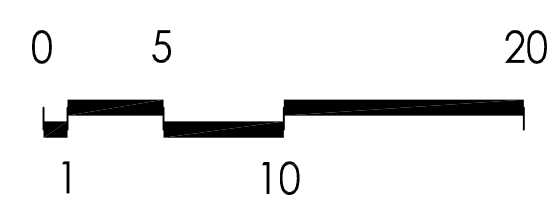


KEY


○ ROOM NUMBER
 □ DOOR NUMBER

Third Floor Plan
 PACIFIC LUTHERAN UNIVERSITY
 HARSTAD HALL - AS-BUILT

Job #:
 Date: August 7, 2014
 Revs:

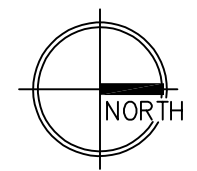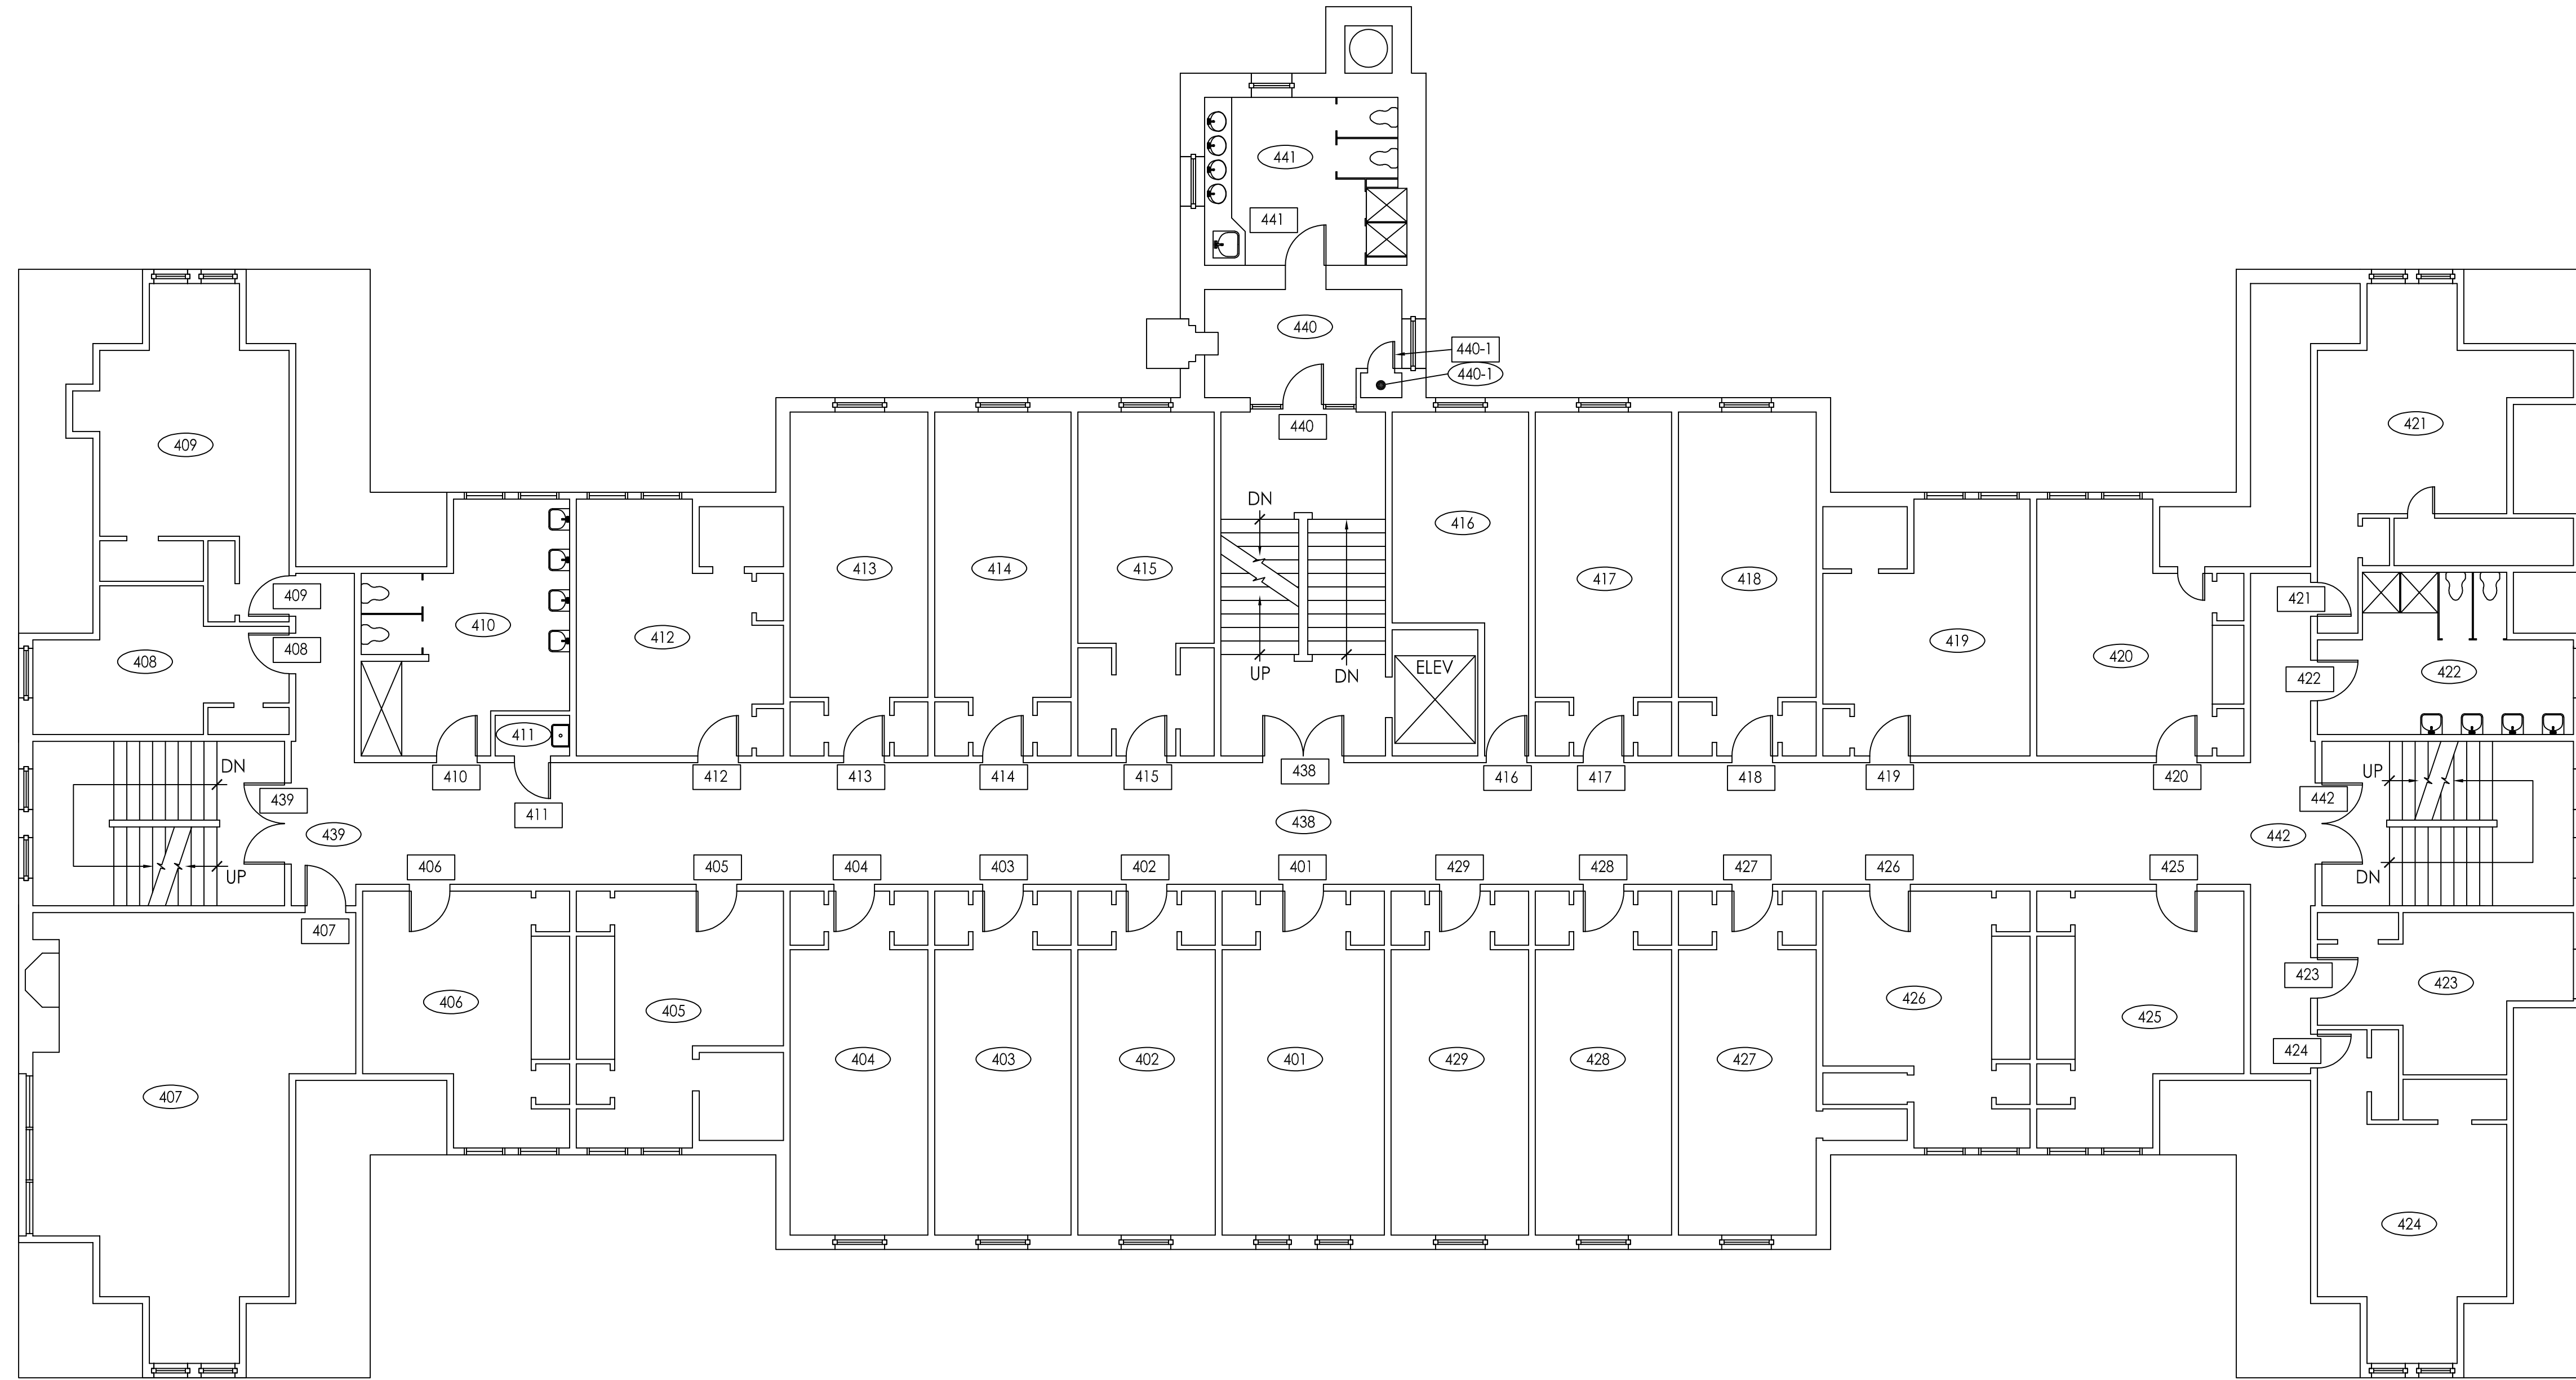



HARSTAD HALL - FOURTH FLOOR PLAN
 22x34 - 1/8" = 1'-0"
 11x17 - 1/16" = 1'-0"

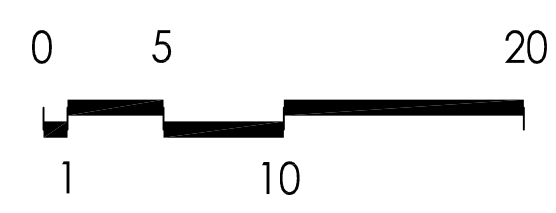


KEY
 ○ ROOM NUMBER
 □ DOOR NUMBER

Fourth Floor Plan
 PACIFIC LUTHERAN UNIVERSITY
 HARSTAD HALL - AS-BUILT

Job #:
 Date: August 7, 2014
 Revs:

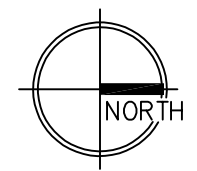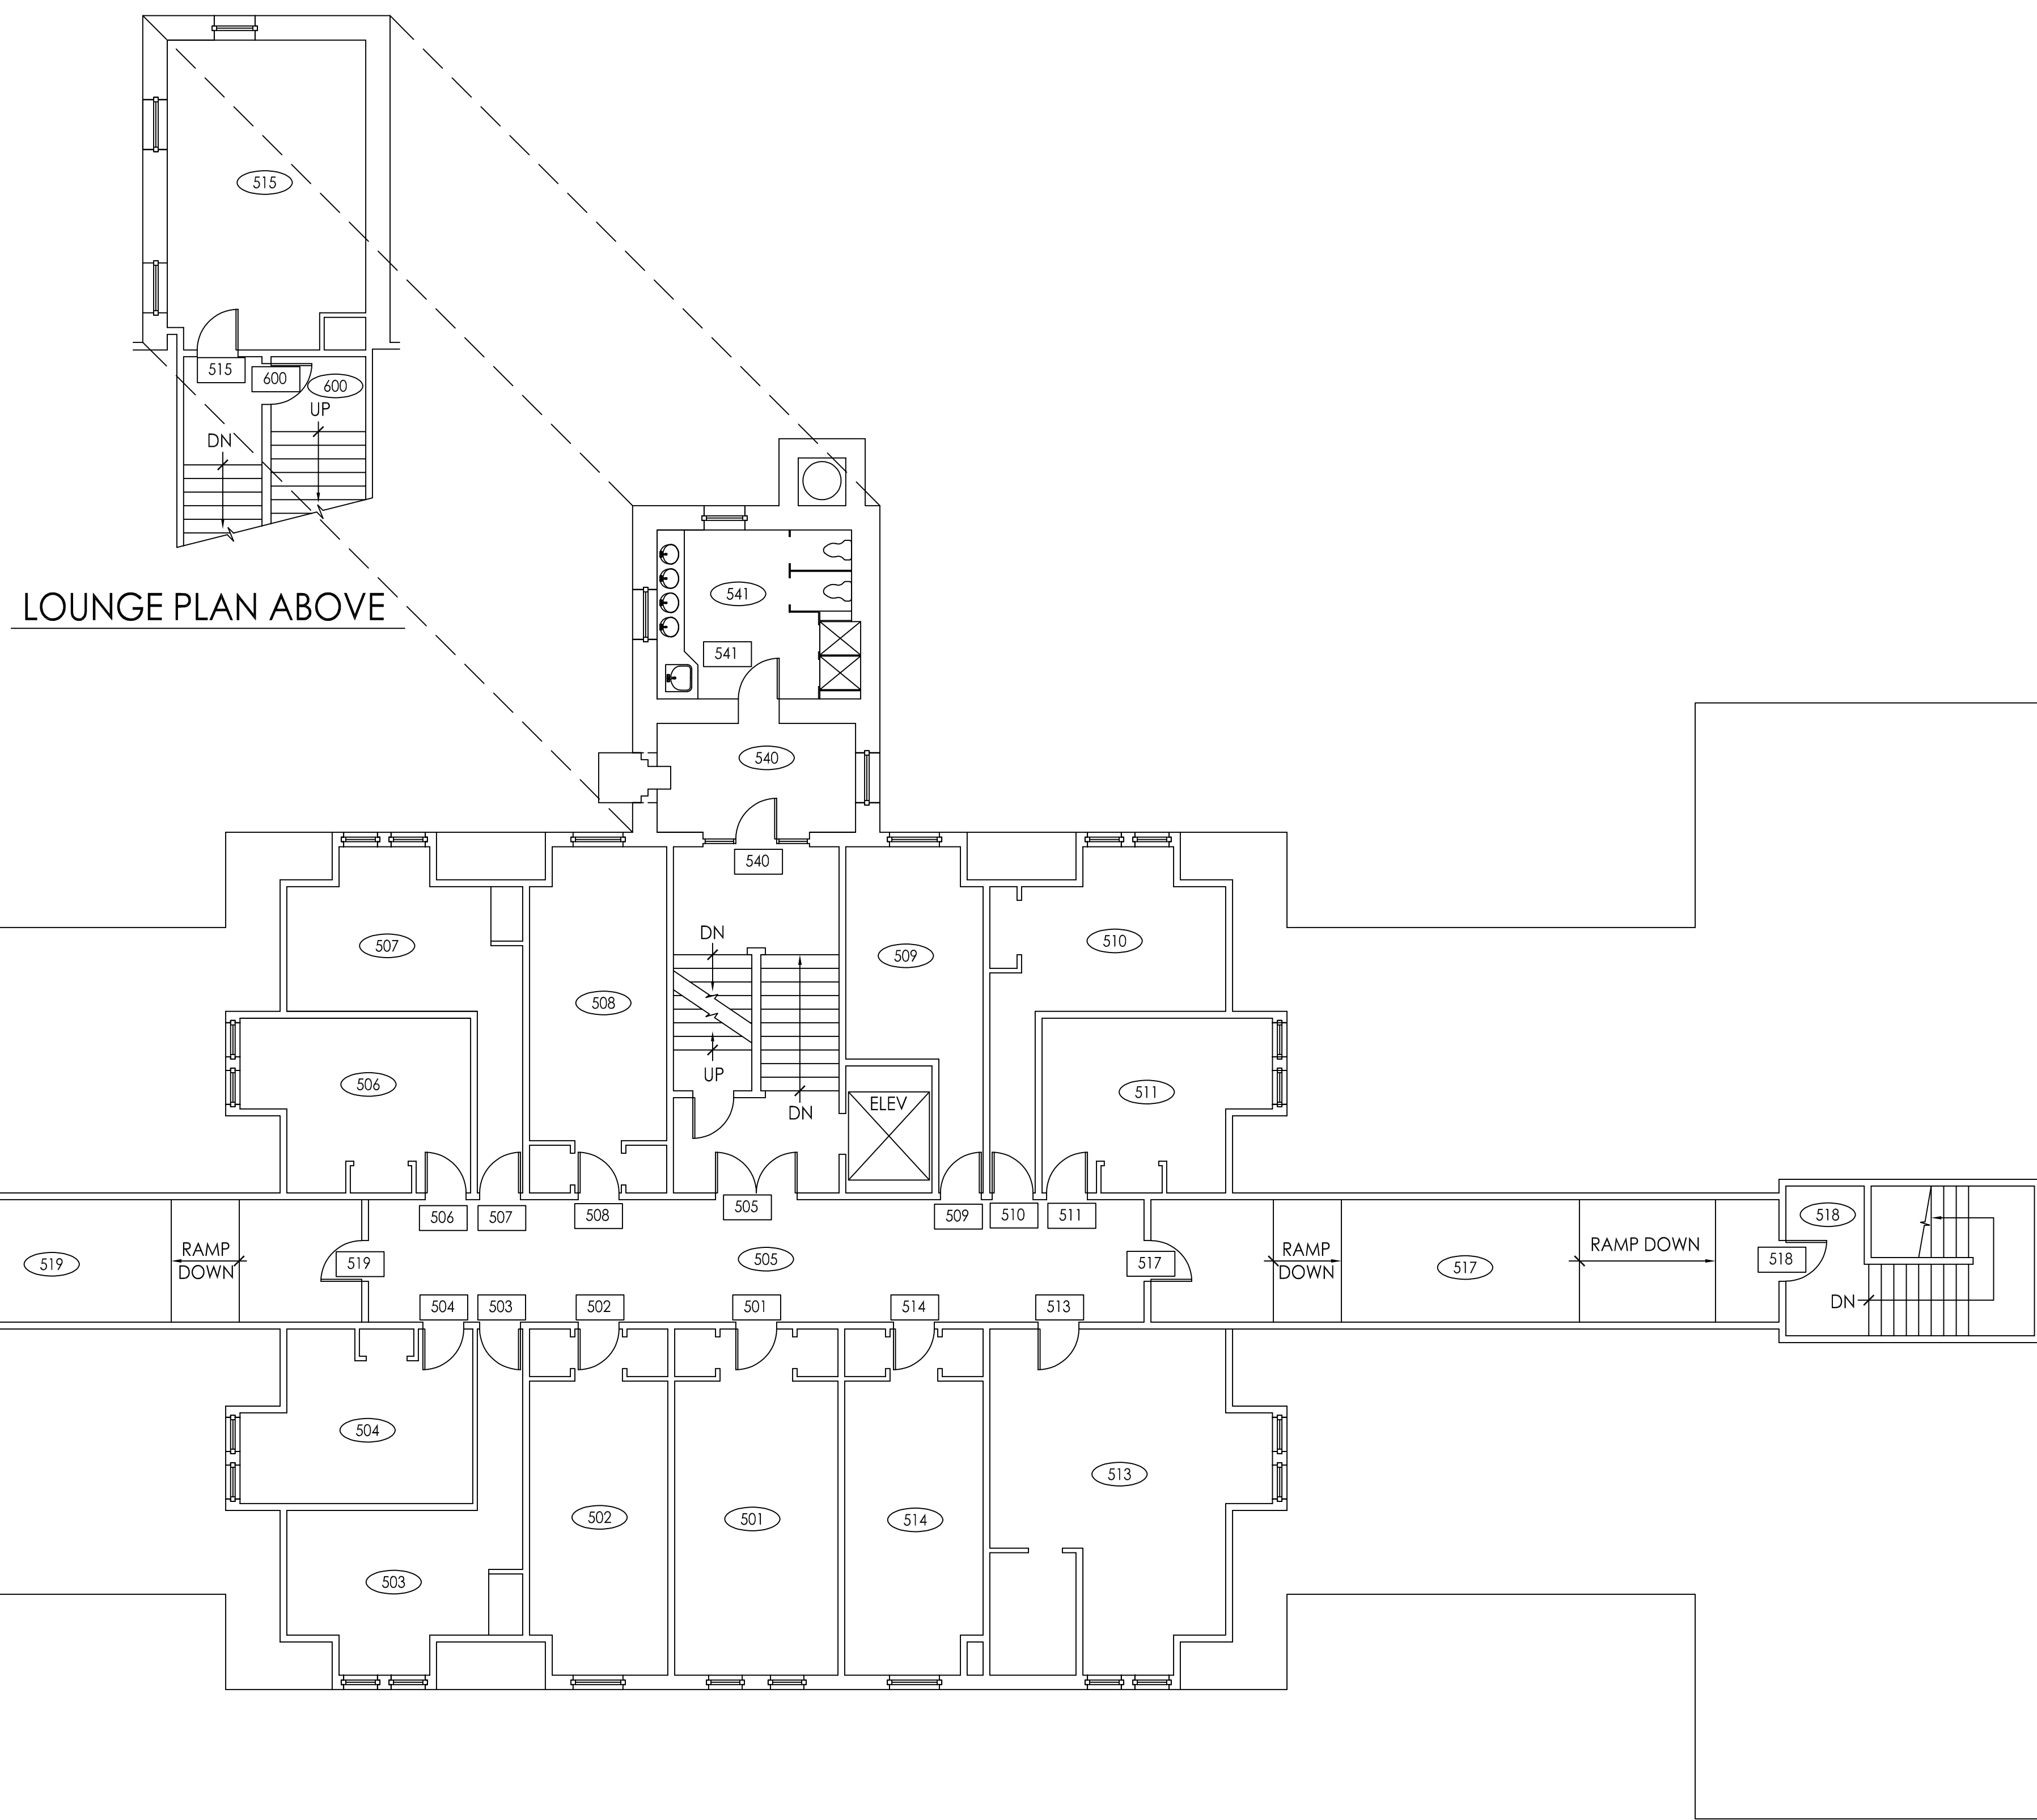

HARSTAD HALL -FIFTH FLOOR PLAN
 22x34 - 1/8" = 1'-0"
 11x17 - 1/16" = 1'-0"

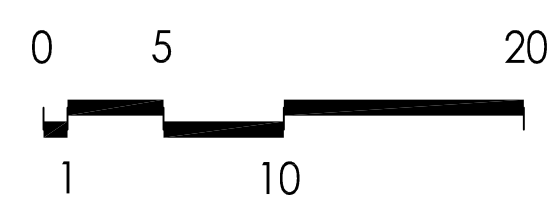

KEY
 ○ ROOM NUMBER
 □ DOOR NUMBER

Fifth Floor Plan
 PACIFIC LUTHERAN UNIVERSITY
 HARSTAD HALL - AS-BUILT

Job #:
 Date: August 7, 2014
 Revs: